


Attachment B - Fiber Ring Diagram ~ Current Network Topology

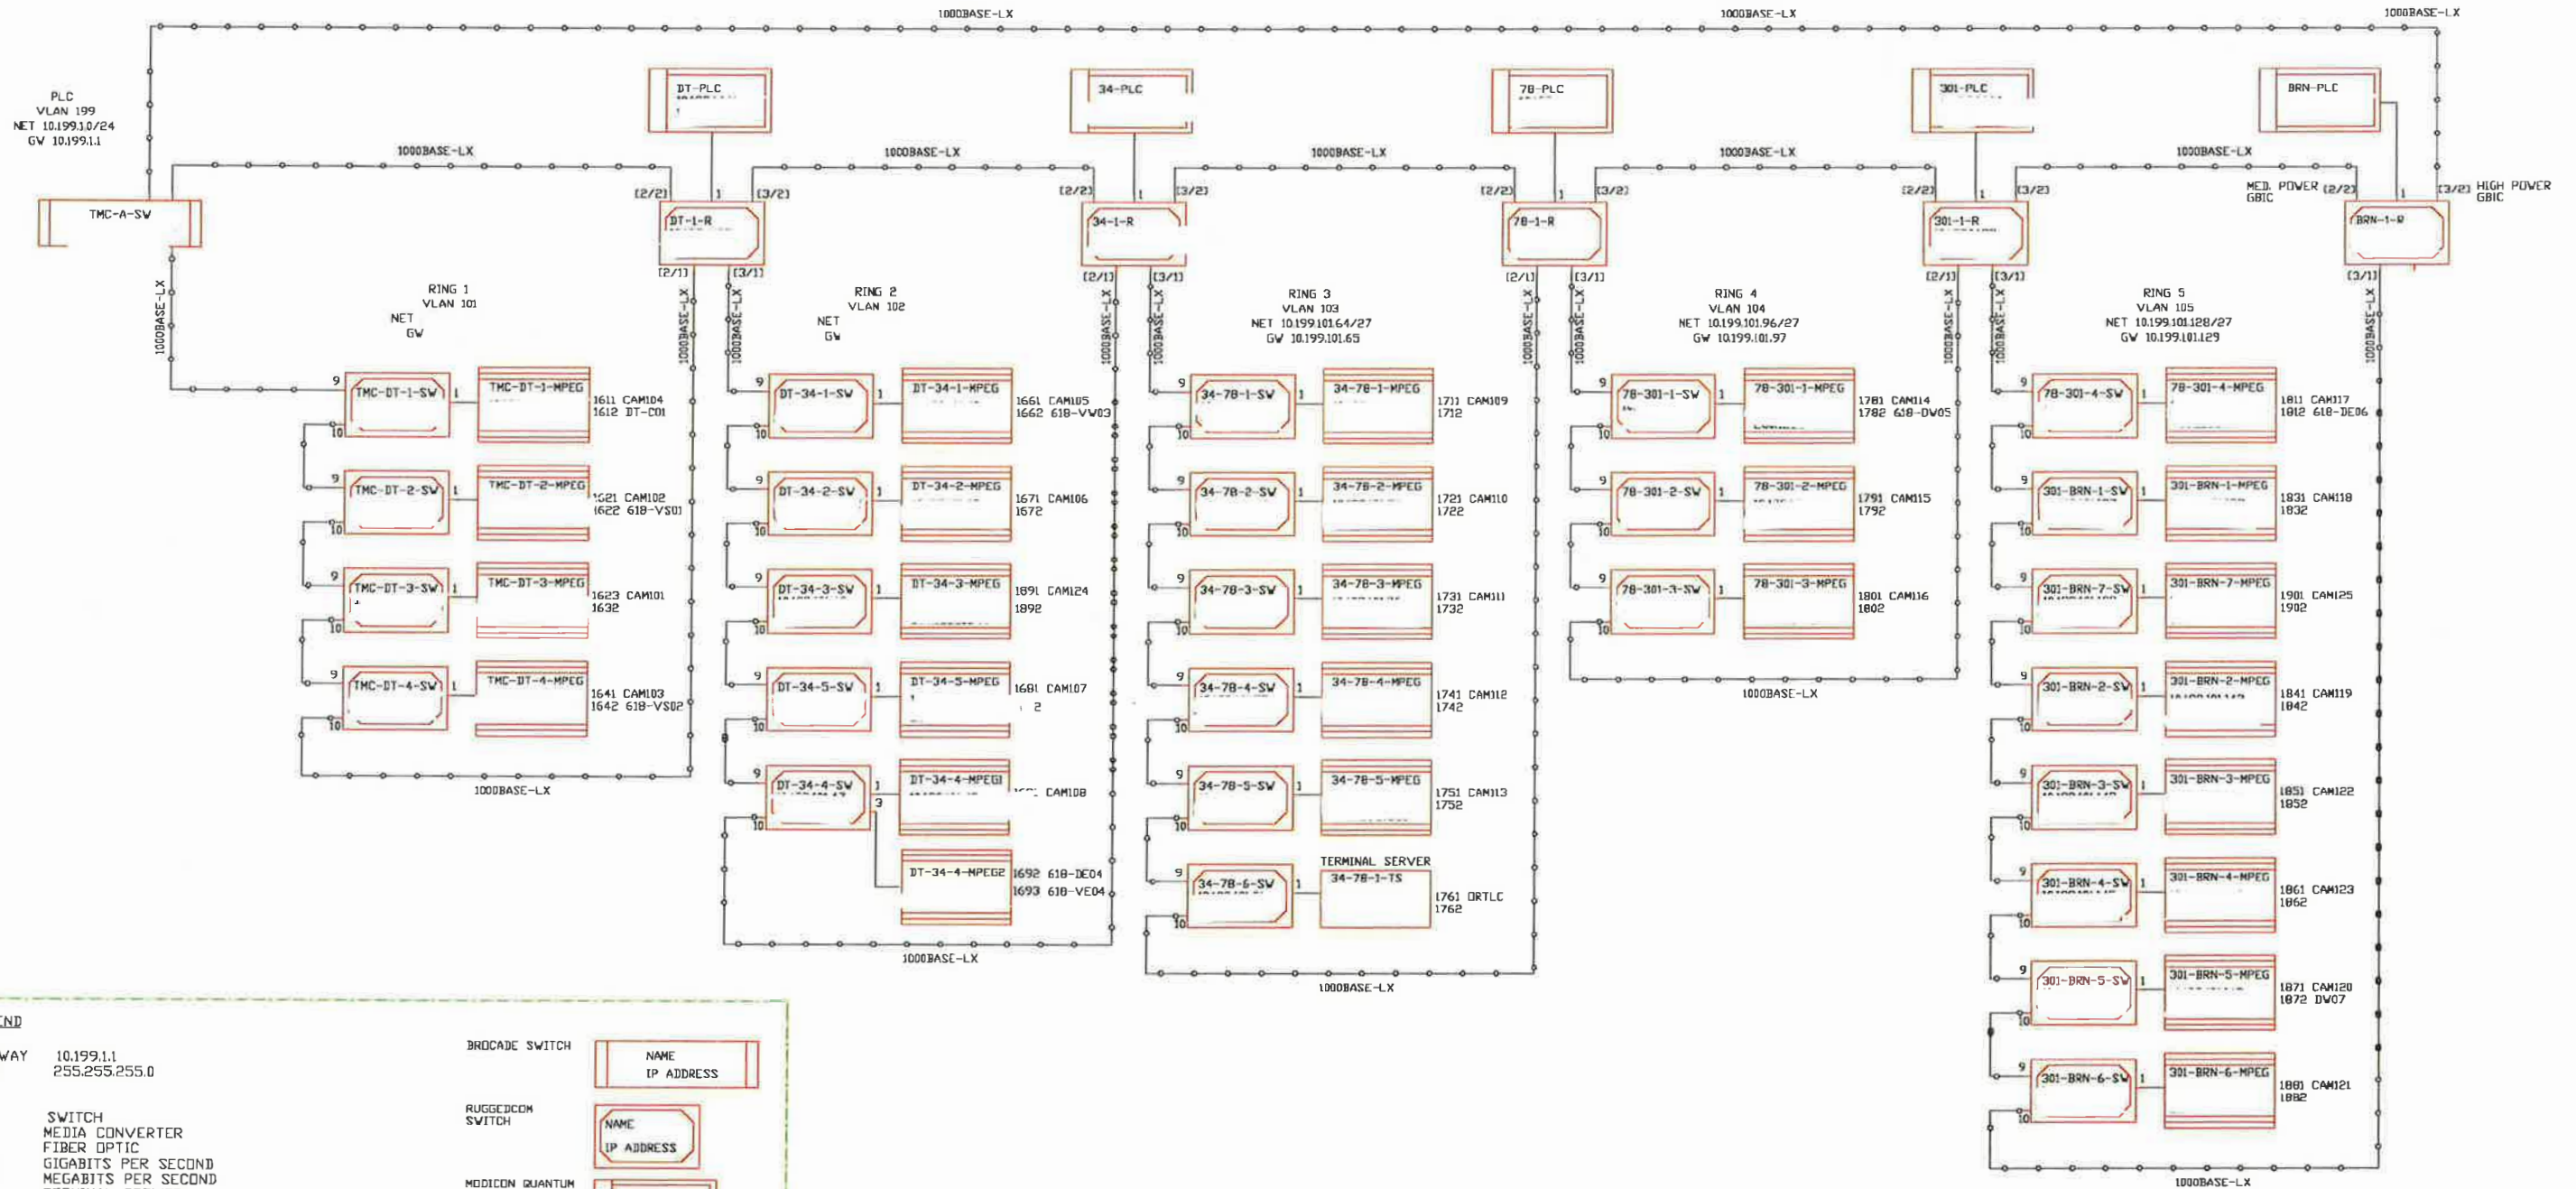

**LEGEND**

GATEWAY MASK	10.199.1.1 255.255.255.0	BROADCOM SWITCH	NAME IP ADDRESS
SW	SWITCH	RUGGEDCOM SWITCH	NAME IP ADDRESS
MC	MEDIA CONVERTER	MODICON QUANTUM PLC	NAME IP ADDRESS GATEWAY
FO	FIBER OPTIC	TELLESTE VIDEO ENCODER	NAME IP ADDRESS MULTICAST
GBPS	GIGABITS PER SECOND	DIGI PORT SERVER	NAME IP ADDRESS
MBPS	MEGABITS PER SECOND		
TS	TERMINAL SERVER		
DT	DOWNTOWN		
BRN	BRANDON		
PLC	PROGRAMMABLE LOGIC CONTROLLER		
TMC	THEA MANAGEMENT CENTER		
SFF	SMALL FORM-FACTOR PLUG		
ORTLC	OPEN ROAD TOLL LANE CONTROLLER		
[#]	1000BASE-LX FIBER-OPTIC PORT		
#	ETHERNET PORT		

FIBER-OPTIC CABLE  
 ETHERNET (CAT-5/6) CABLE

**NOTE:**

PROPRIETARY INFORMATION: THIS DRAWING CONTAINS TRANSDYN CONTROL'S INC. PROPRIETARY DATA AND IS NOT TO BE COPIED, REPRODUCED, USED OR DIVULGED TO UNAUTHORIZED PERSONS, IN WHOLE OR IN PART, WITHOUT WRITTEN AUTHORIZATION FROM TRANSDYN CONTROL'S, INC.

DESIGNED BY	F. POPOV	E	07-15-14	COMPONENT REPLACEMENT - RUGGEDCOM	CB	CB
DRAWN BY	F. POPOV	D	02-07-08	AS BUILT - NEW CAMERAS	FP	WW
CHECKED BY	W. WOODSIDE	C	11-10-09	REVISED - NEW CAMERAS	FP	WW
DATE:	07-21-06	B	11-10-09	AS-BUILT	FP	WW
UPDATE:	07-15-14	A	7-21-06	ISSUED FOR APPROVAL	FP	WW
		REV.	DATE	DESCRIPTION	BY	APP.



**COMMUNICATIONS NETWORK DIAGRAM**  
**FIBER-OPTIC REDUNDANT COMMUNICATION RING**

TAMPA HILLSBOROUGH EXPRESSWAY AUTHORITY  
 REVERSIBLE EXPRESS LANE ITS

SCALE:	NONE	JOB NO.	3042
CAD FILE NO.	3042-1001-01	SHT. OF	1 1
DRAWING NO.	3042-1001-01REV2	REV.	D